


# PROPOSED NEW BUSINESS UNITS E & F

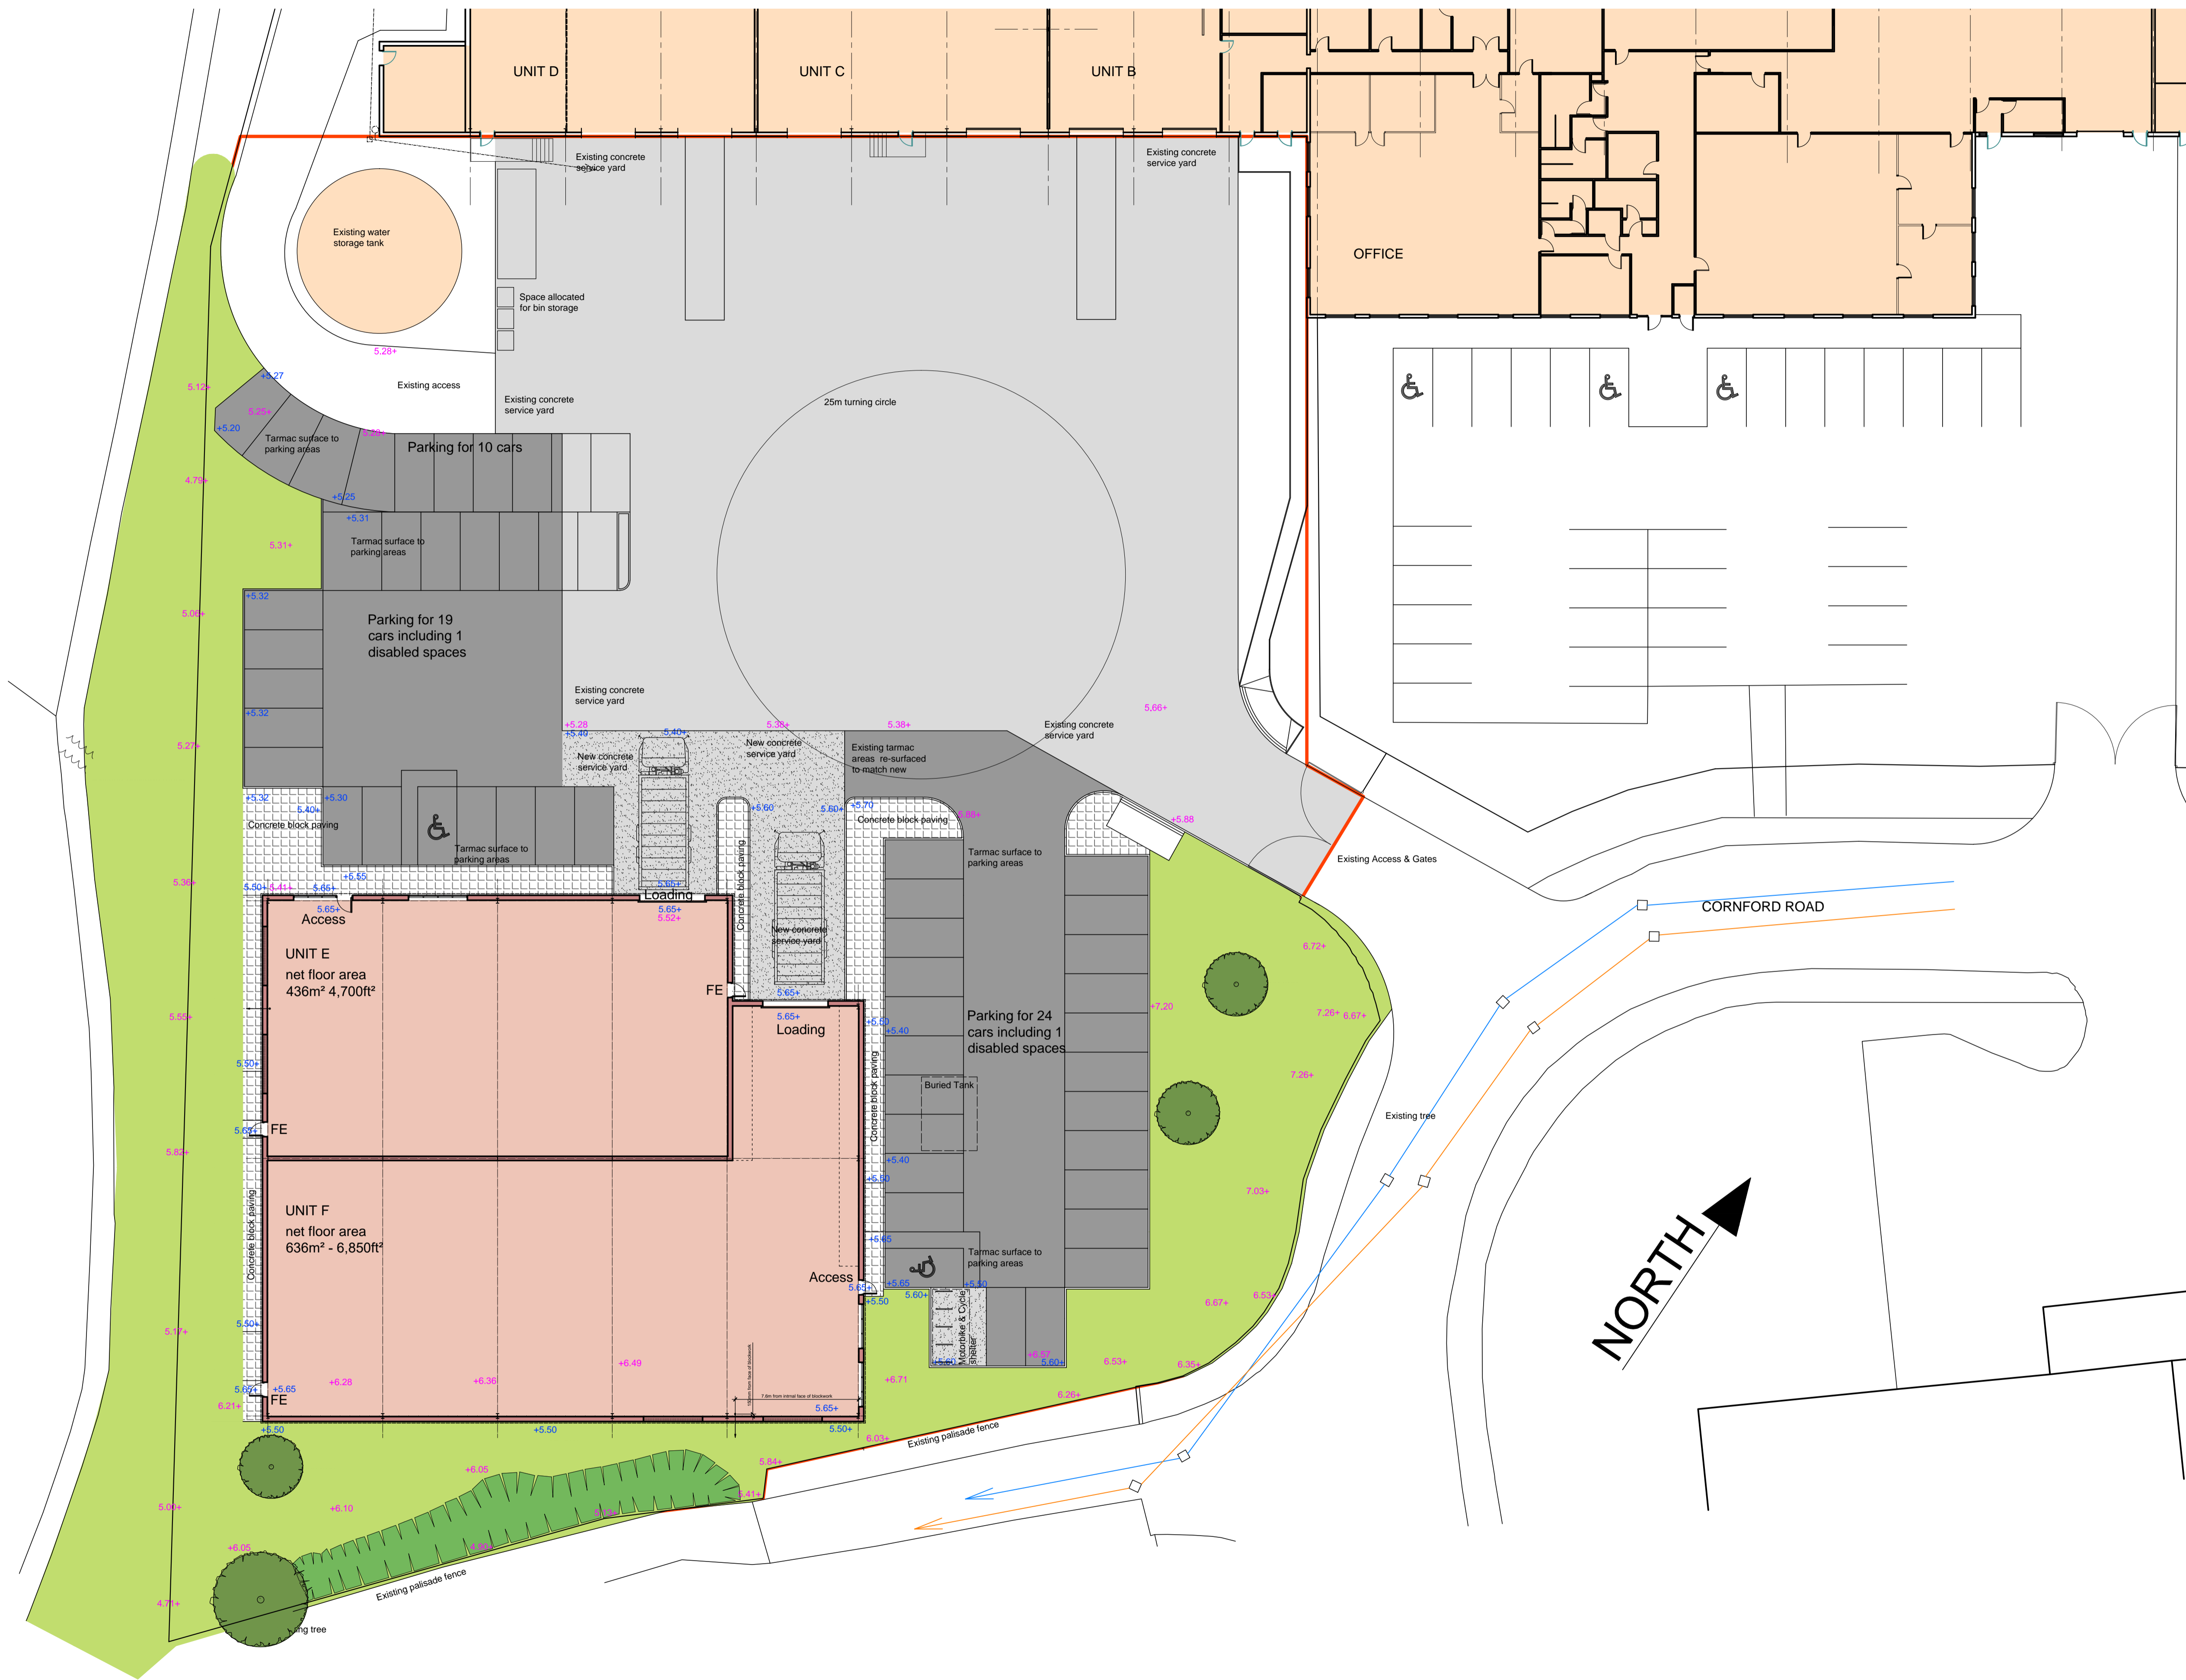

- NOTES**
- This drawing is copyright. No unauthorised copying of drawing without the express permission of the architect.
  - Do not scale from prints. Use figure dimensions only.
  - Contractors to check all dimensions on site prior to commencement of works.
  - All works to be carried out in accordance with current statutory Health and Safety Regulations.
  - This drawing is to be read in conjunction with all relevant consultants' and / or specialists' drawings / documents and any discrepancies or variations are to be notified to the architect before affected work commences.

REV.	AMENDMENTS	DATE
Rev A	As built car park layout	17-01-26

- +5.00 Proposed Levels
- +5.00 Existing Levels

Project	PRESTIGE HOUSE DEVELOPMENT CORNFOR ROAD, BLACKPOOL
Drawing	CONSTRUCTION - PROPOSED UNITS E & F BLOCK PLAN
Client	HENCO INTERNATIONAL LTD
Dwn. By	NP
Scale	1:200
Drg. No.	14-06-225-A
Drg. Size	A1
Date	FEBRUARY 2016

**PDP** Tel: 01706218170  
 Email: mail@peelidesigns.co.uk  
 Web: www.peelidesigns.co.uk  
 RIBA Chartered Practice 20001293  
 Peel Design Partnership Ltd  
 Hillsford New Barn Lane Rawtenstall Lancashire B84 6HT

PROPOSED BUILDING BLOCK PLAN @ 1:200

