



- NOTES**
- This drawing is copyright. No unauthorised copying of drawing without the express permission of the architect.
 - Do not scale from prints. Use figure dimensions only.
 - Contractors to check all dimensions on site prior to commencement of works.
 - All works to be carried out in accordance with current statutory Health and Safety Regulations.
 - This drawing is to be read in conjunction with all relevant consultants' and / or specialists' drawings / documents and any discrepancies or variations are to be notified to the architect before affected work commences.


REV. AMENDMENTS DATE

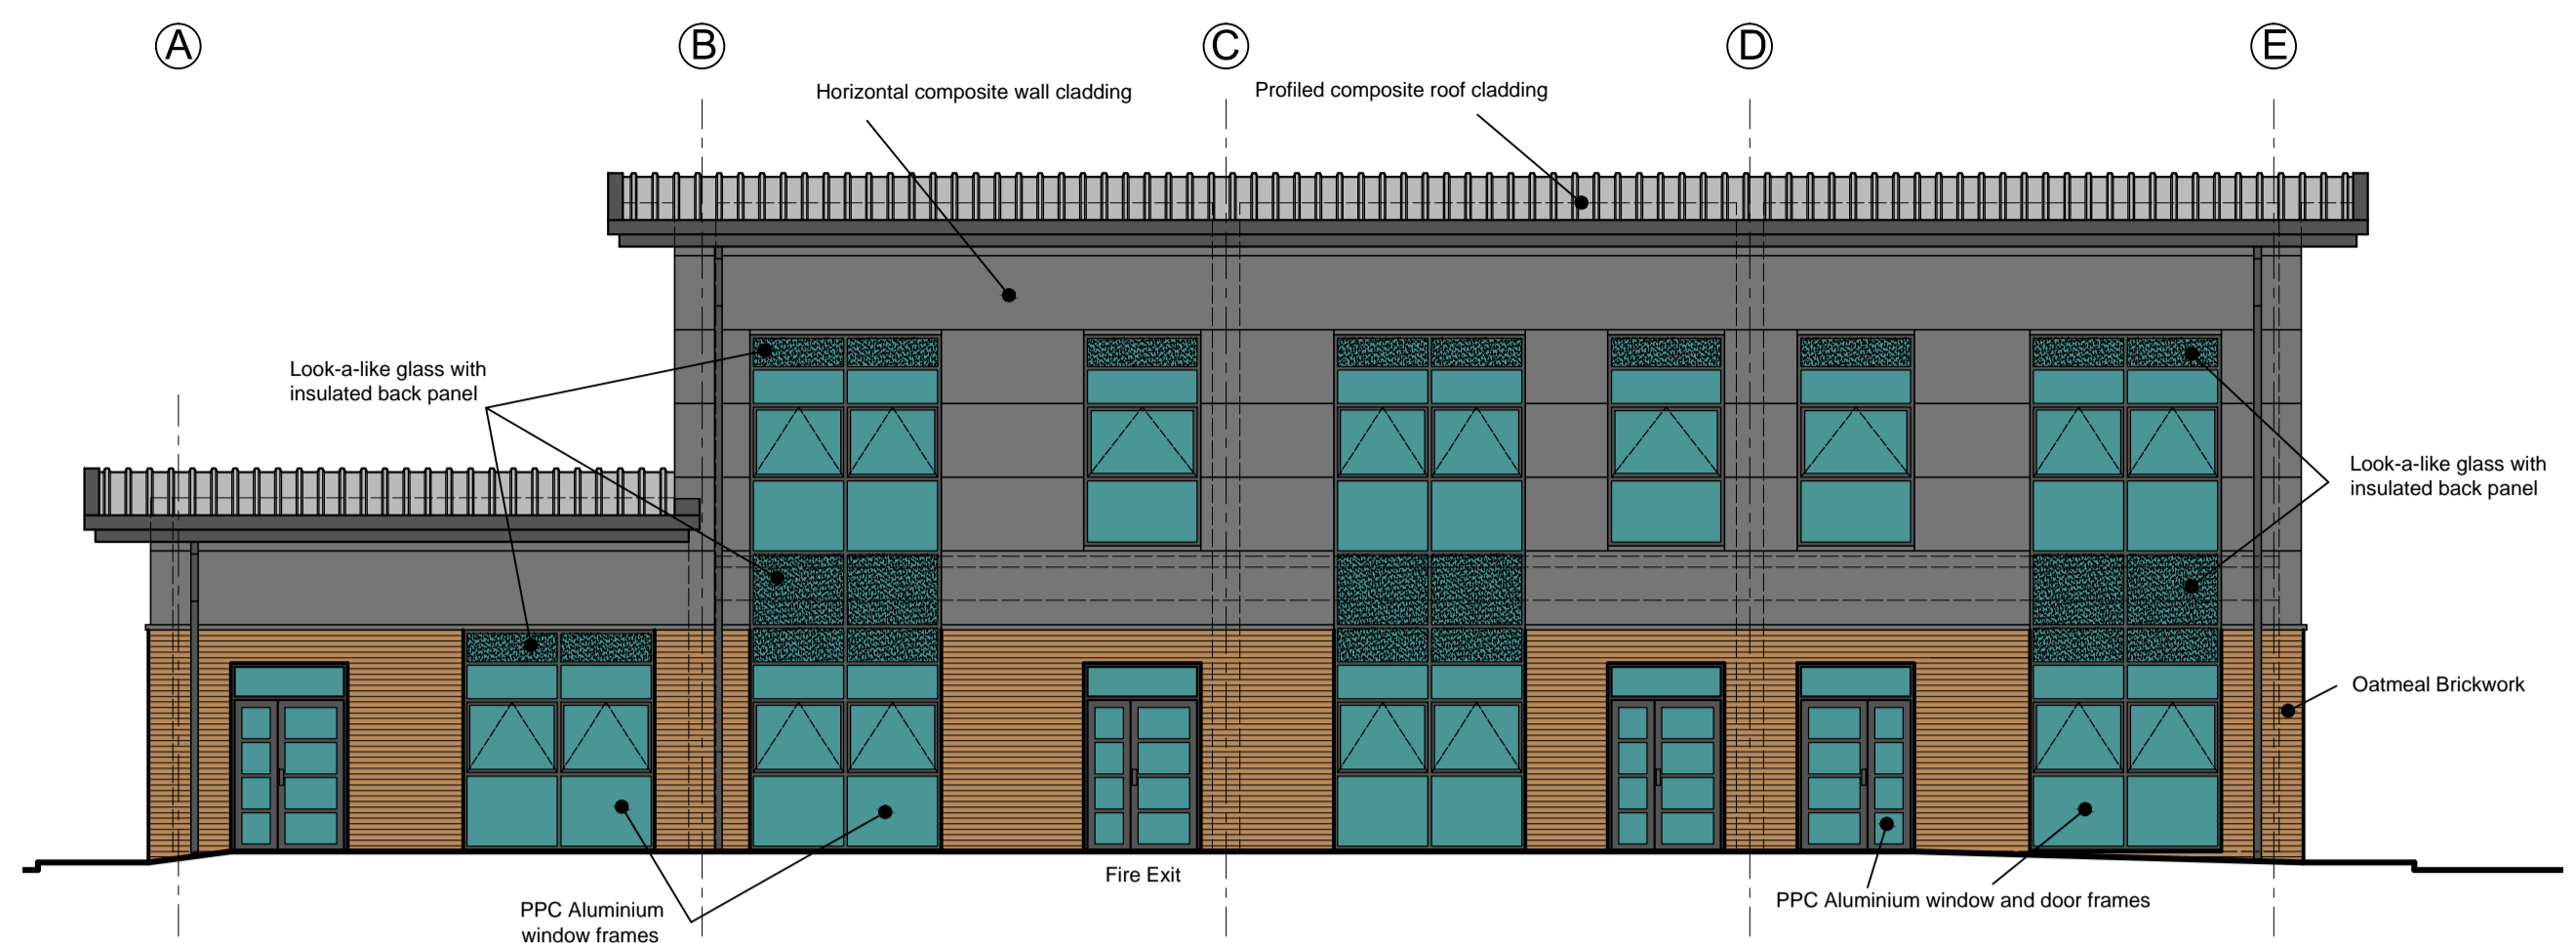


PROPOSED NORTH EAST ELEVATION

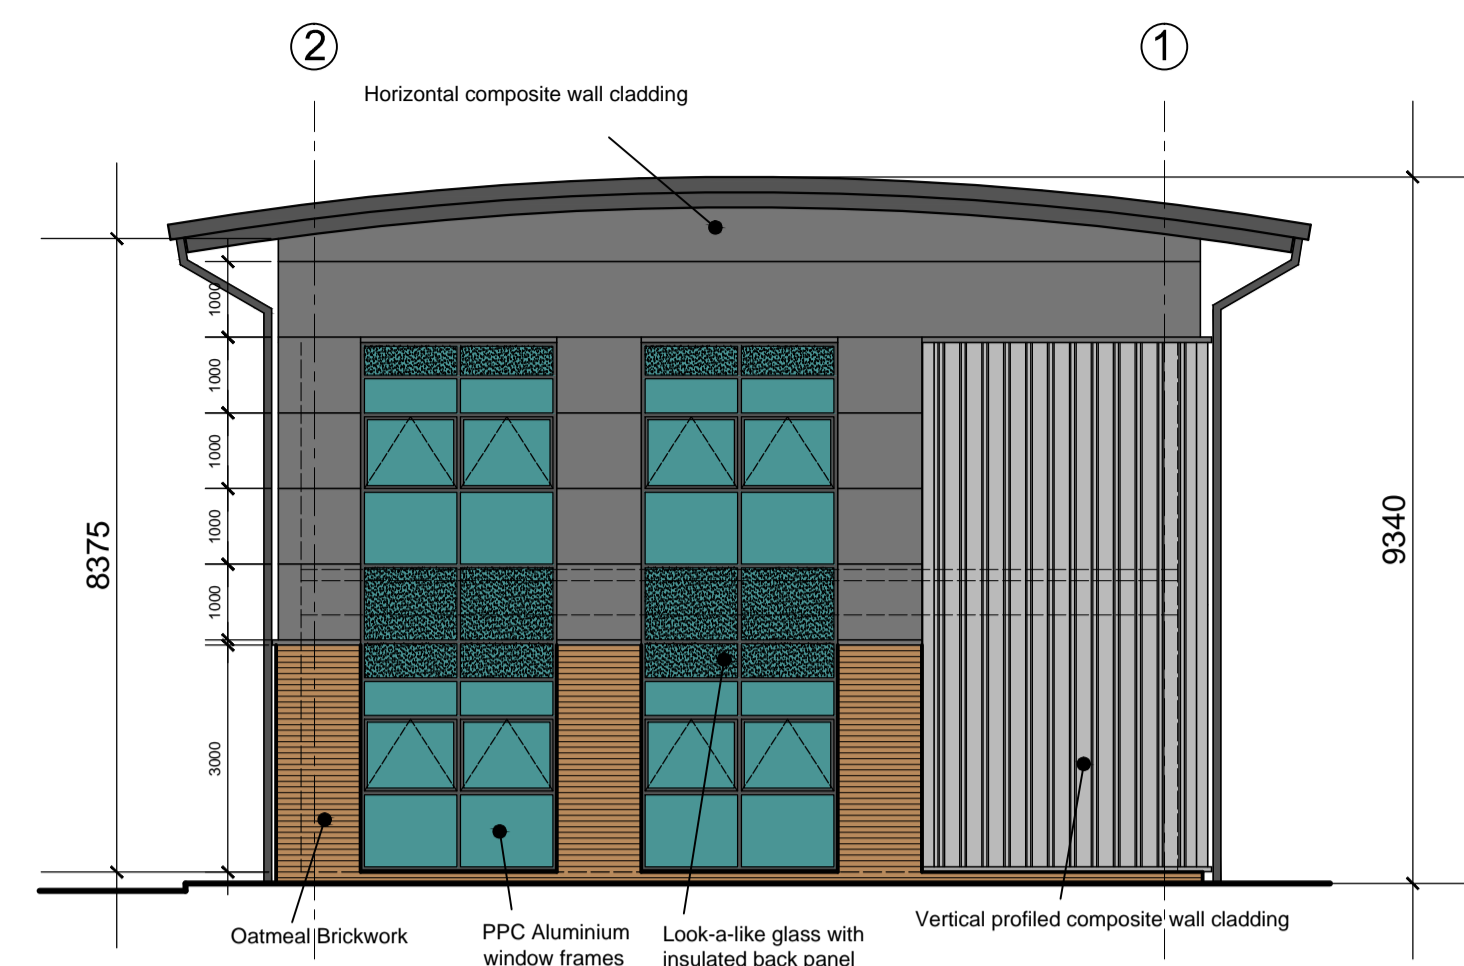


PROPOSED NORTH WEST ELEVATION

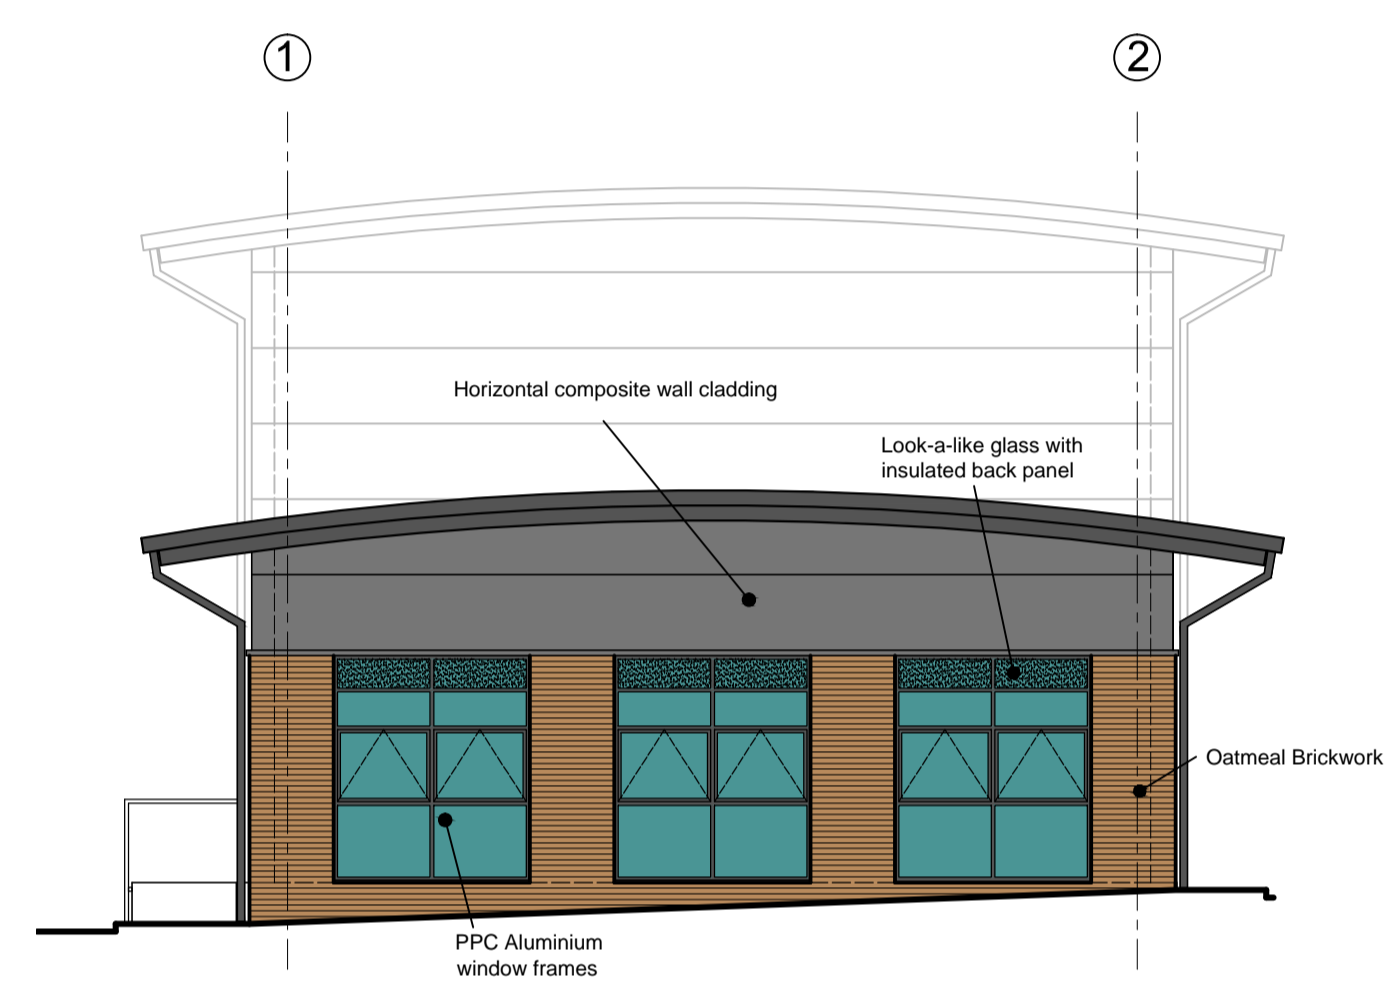


PROPOSED SOUTH EAST ELEVATION

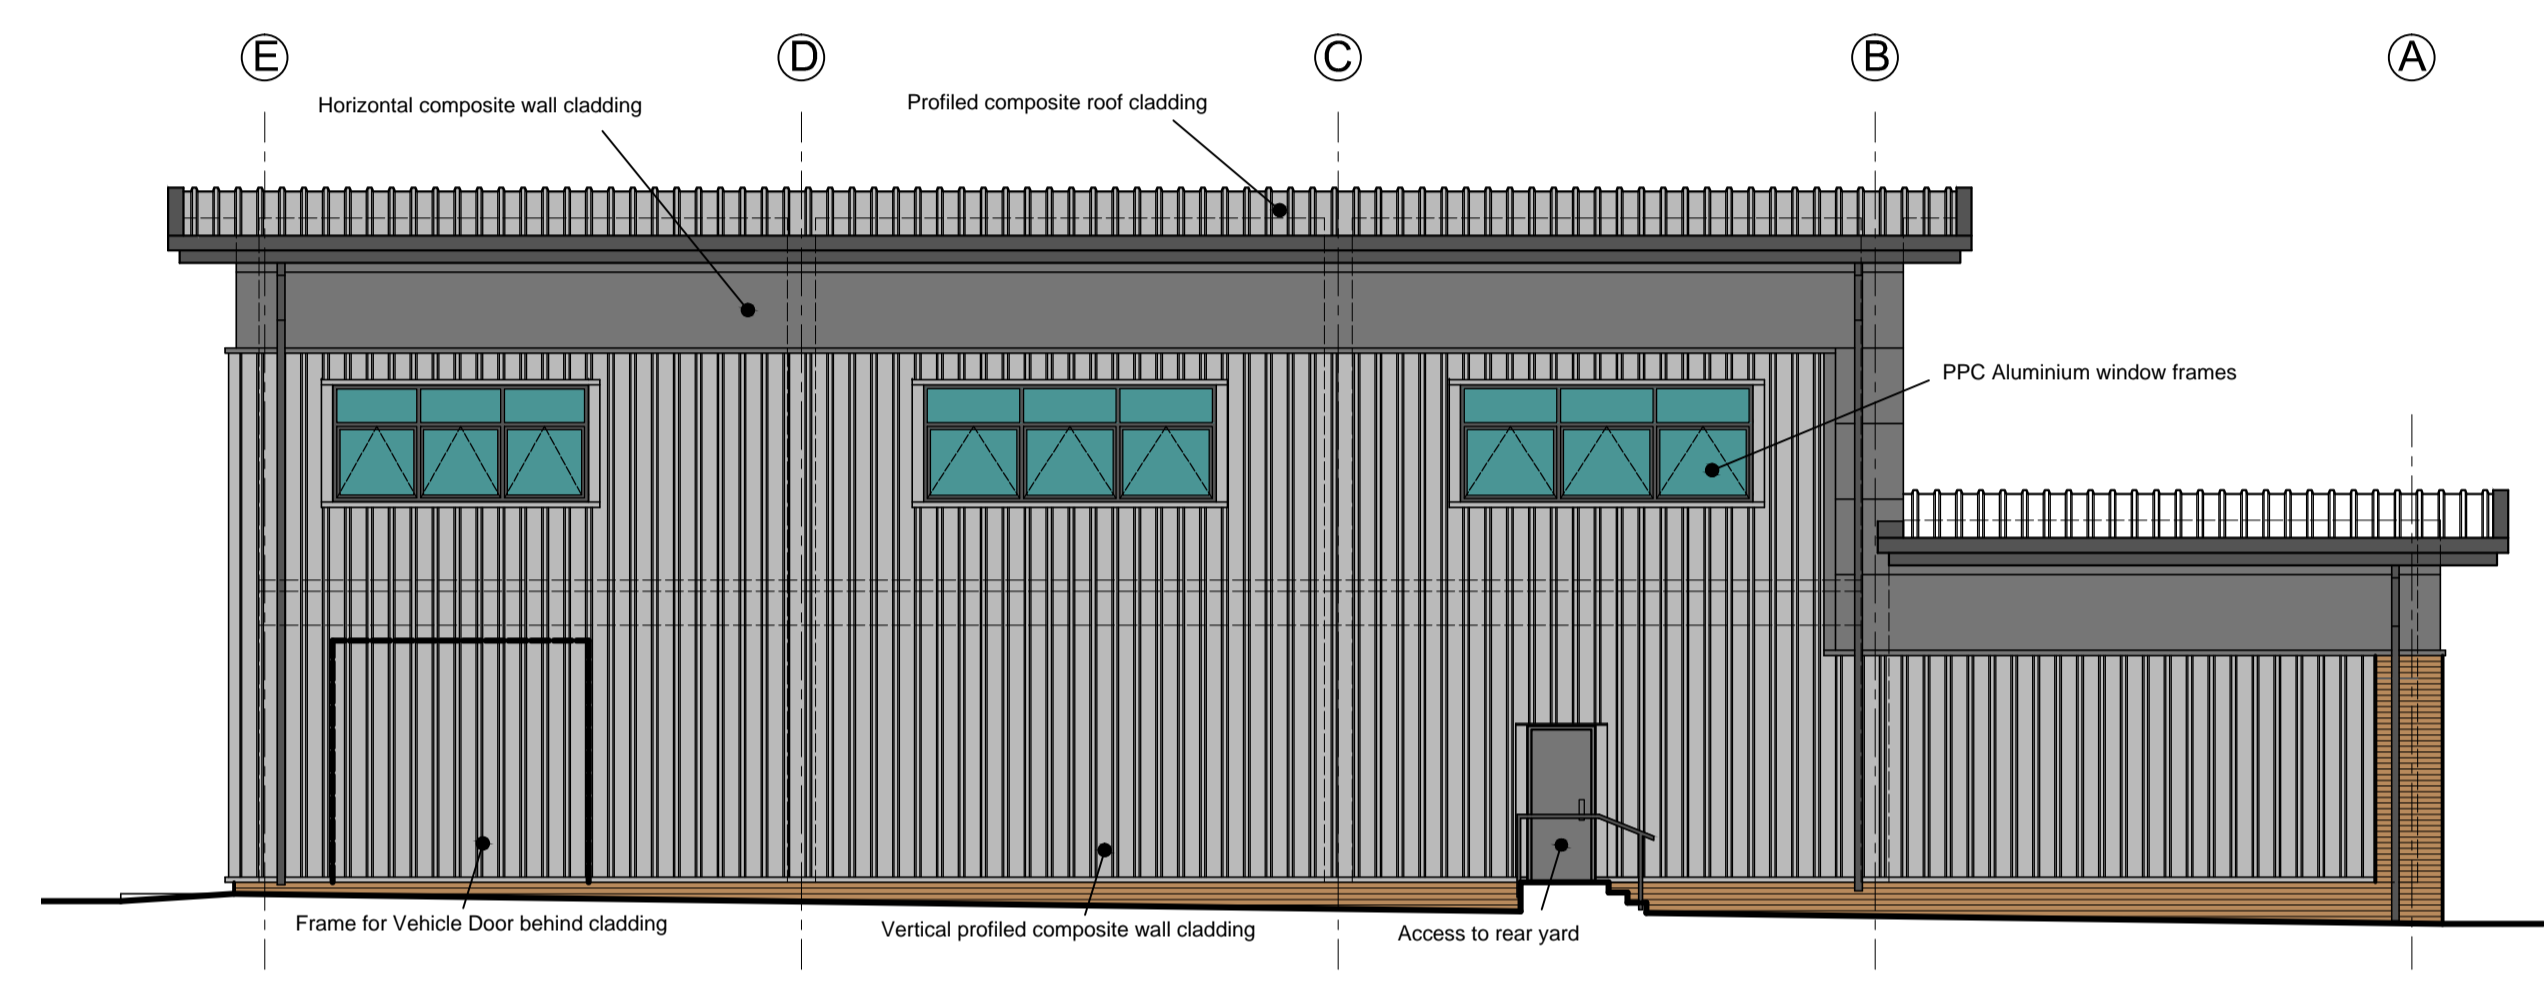

PROPOSED SOUTH WEST ELEVATION

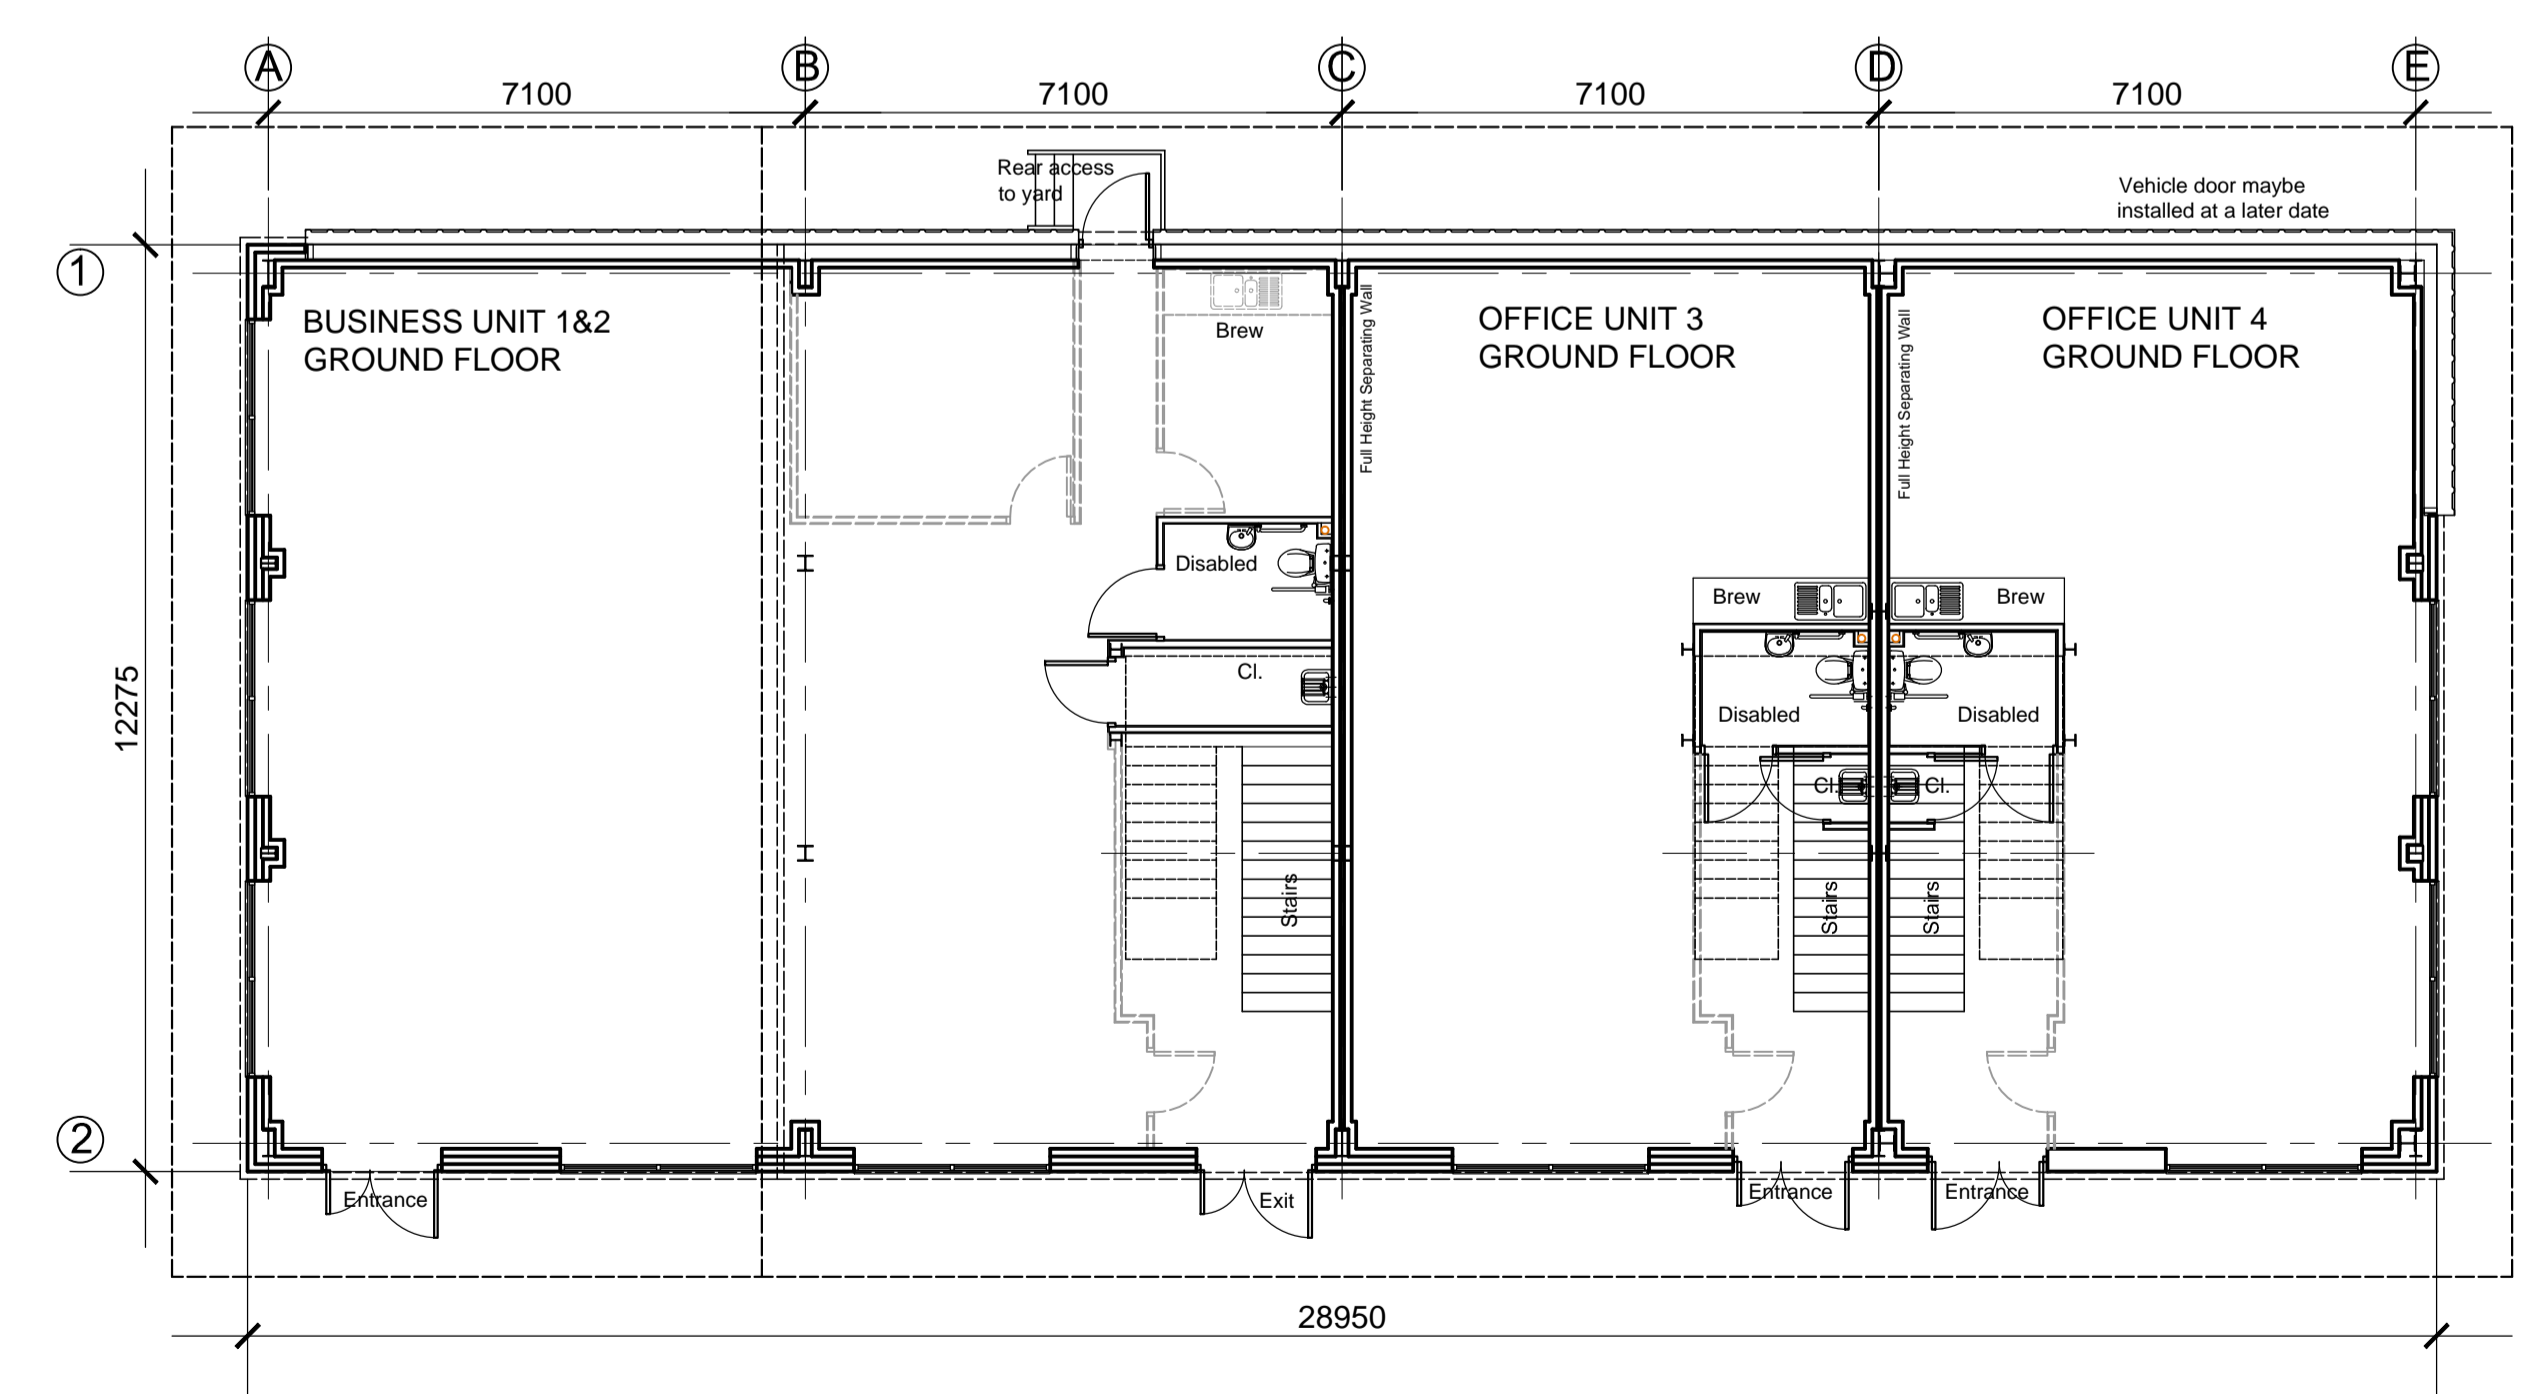

PROPOSED GROUND FLOOR PLAN

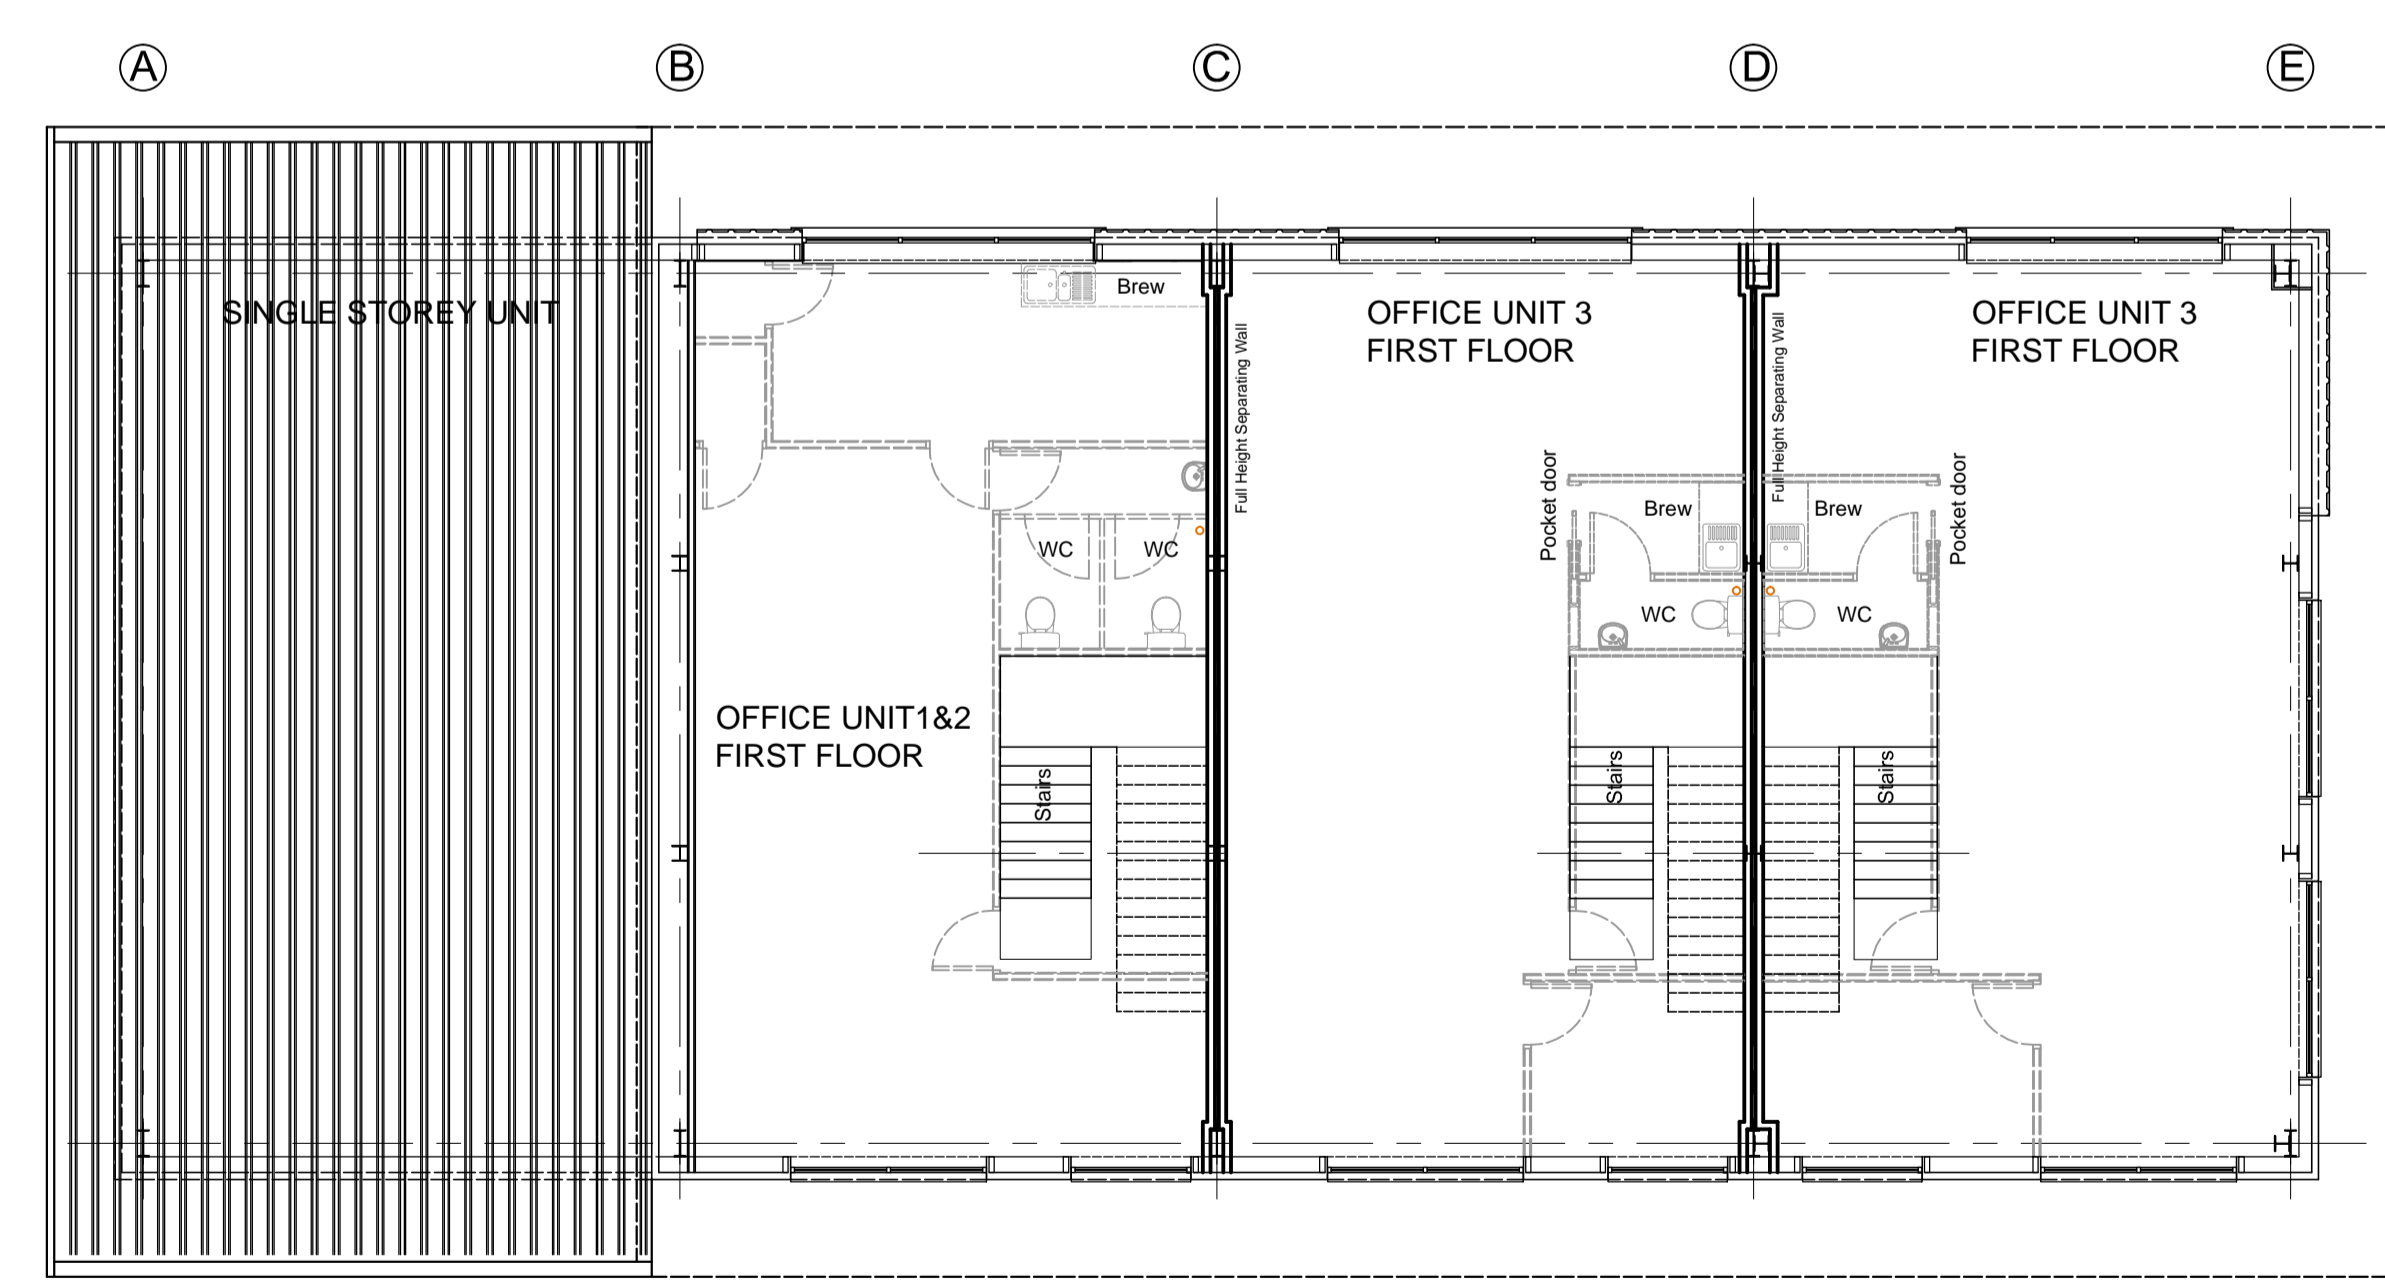

PROPOSED FIRST FLOOR PLAN

Project	PROPOSED BUSINESS UNITS DEVELOPMENT SITE 5 WHITEHILLS BUSINESS PARK
Drawing	BUSINESS UNITS PROPOSED FLOOR PLANS & ELEVATIONS CONSTRUCTION 'AS BUILT'
Client	HENCO INTERNATIONAL LTD
Dwn. By	NP
Scale	1:100
Drg. No.	15-06-S5-25 AS BUILT
Drg. Size	A1
Date	APRIL 2017